

Existing lot
13,000 s.f.

Condie Plat
10/4/2013

THE CITY OF KIRKLAND

SIDE SEWER PERMIT

FOR

EASEMENT NO.

OWNER Almqvist & Bradley

CONTRACTOR Lake Side

Septic

PERMIT NO. 849

HOUSE NO. 1118 2nd Street

STREET

AVENUE LOT NO.

BLOCK NO.

ADDITION

NO. OF UNITS IN BUILDING

OVERFLOW ELEVATION

STUB-IN ELEVATION

HOUSE ELEVATION


LOT SIZE NOT TO SCALE - SHOW FRONT OF LOT - SHOW APPROXIMATE HOUSE SIZE AND LOCATION ON LOT - SHOW SEWER LINE

FEET (APPROX.)

NOV 02 1972

CITY OF KIRKLAND

Treasurer

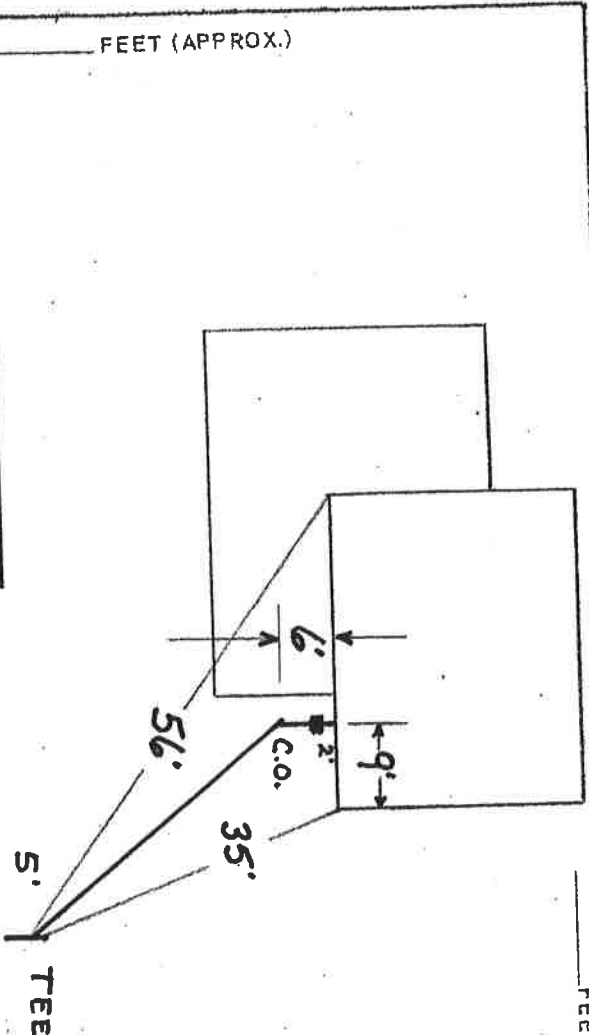

FEET (APPROX.)

APPLICANT HEREBY AGREES

to install, pursuant to the requirements of Ord. # 874, an approved backwater sewage valve and further agrees to save and hold harmless the city of Kirkland from any and all damage which may result therefrom.

Signature Almqvist Date 10-2-72

FEET (APPROX.)

OUTSIDE CITY

25.00

INSIDE CITY

25.00

25.00

AMT. PD.

DATE PD.

RECEIPT NO.

(WATER OR AIR TEST REQUIRED BEFORE BACKFILL) INSPECTION & APPROVED DATE 11-2-72

INSPECTION BY

Paul Davis

SEWER PERMIT


STUB-IN

TRUNKAGE FEE

USE THOSE THAT APPLY



GIS MAPPING PORTAL ~ City of Kirkland, Washington ~ Department of Information Technology

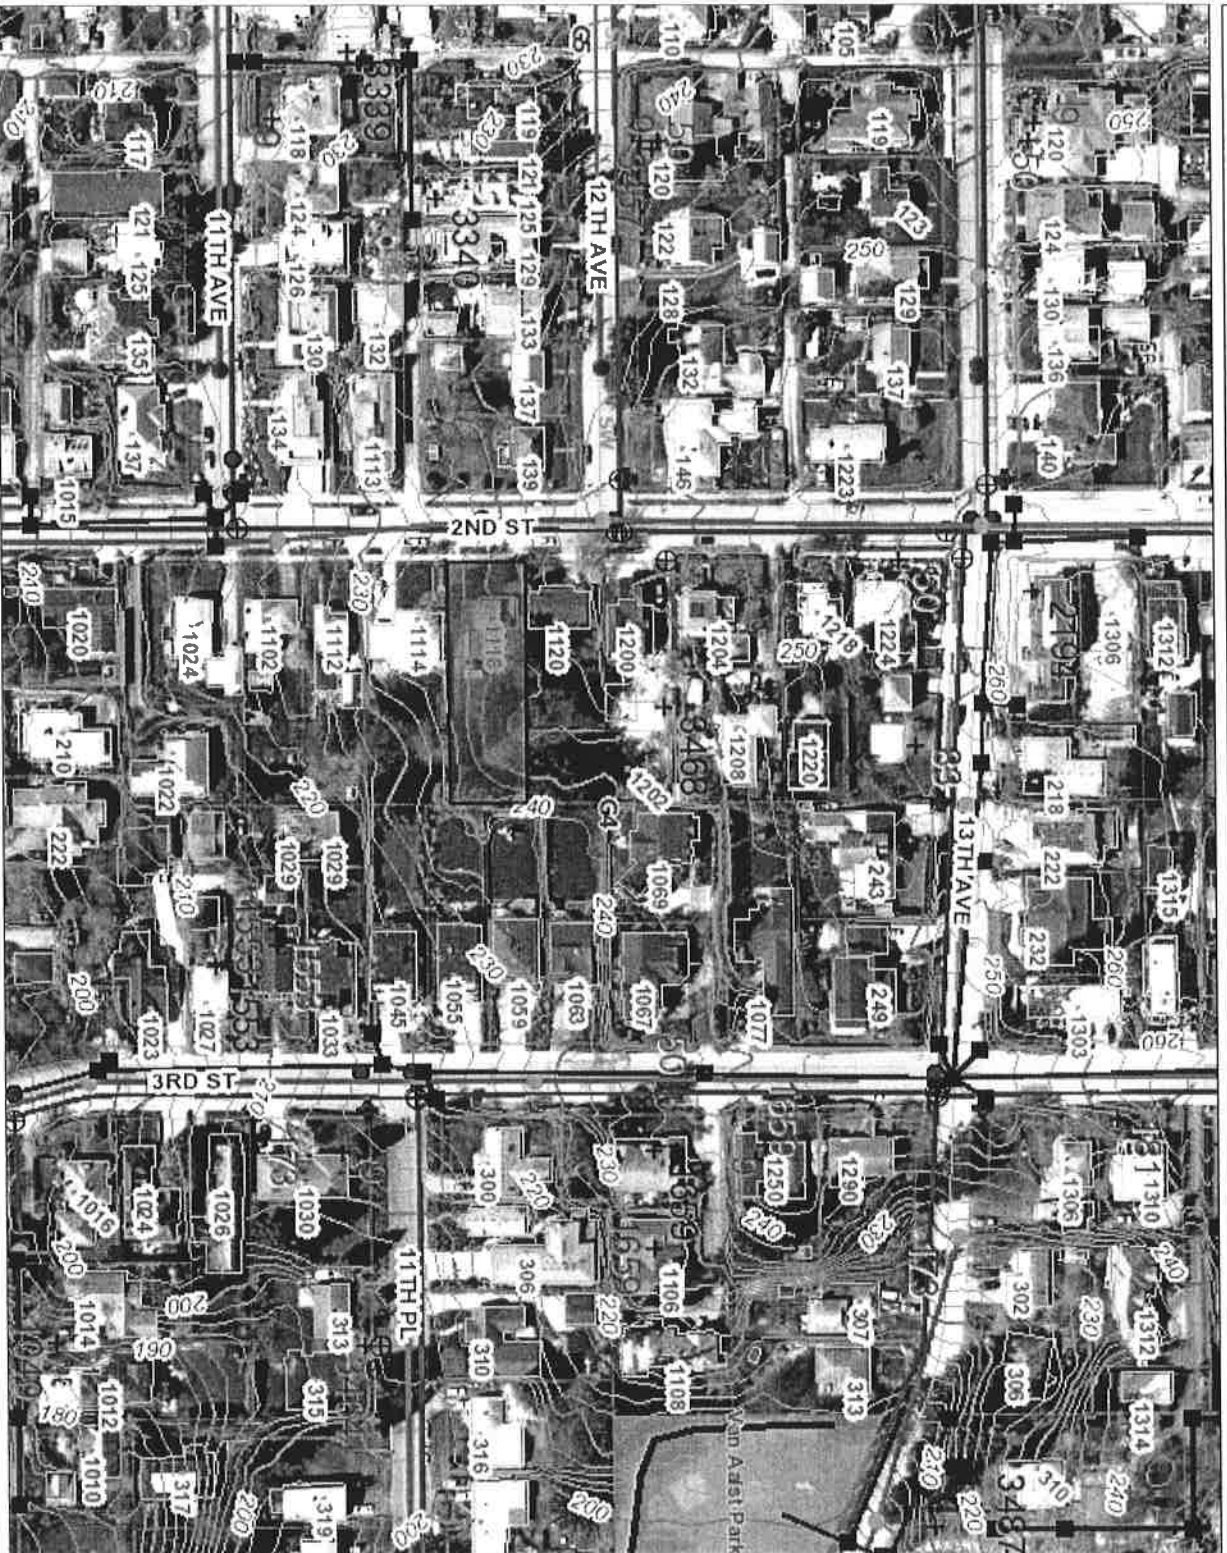

0.1 0 0.03 0.06 Miles
NAD_1983_StatePlane_Washington_North_FIPS_4601_Feet
Produced by the City of Kirkland, © 2013 City of Kirkland, Washington, all rights reserved.

No warranties of any sort, including but not limited to accuracy, fitness or merchantability, accompany this product.

THIS MAP IS NOT TO BE USED FOR NAVIGATION



Legend

- SW Manhole
- SW Main
- SW Channel
- SW Tags
- SW Polys
- Pond
- Tank
- Vault
- SS Lift Station
- SS Manhole
- SS Node
- SS Pipe
- SS Tags
- WA Hydrant
- WA Valve
- PRV/REL
- Water Valve
- Hydrant Valve
- WA Others
- Air/Vac
- Blow Off
- Other
- Sample Stand
- WA Fire Flow Node
- WA Main
- WA Tags
- Contours 10F
- Contours 2F
- Address

1:1,845

Notes

Enter Map Description





GIS MAPPING PORTAL ~ City of Kirkland, Washington ~ Department of Information Technology



NAD, 1983, StatePlane, Washington_North, FIPS_4601_Feet
Produced by the City of Kirkland, © 2013 City of Kirkland, Washington, all rights reserved.

No warranties of any sort, including but not limited to accuracy, fitness or merchantability, accompany this product.

THIS MAP IS NOT TO BE USED FOR NAVIGATION

Legend

- SW Manhole
- SW Misc
- SW Main
- SW Channel
- SW Tags
- SW Polys
- Pond
- Tank
- Vault
- SS Lift Station
- SS Manhole
- SS Node
- SS Pipe
- SS Tags
- WA Hydrant
- WA Valve
- PRV/PREL
- Water Valve
- Hydrant Valve
- WA Others
- Air/Vac
- Blow Off
- Other
- Sample Stand
- WA Fire Flow Node
- WA Main
- WA Lateral
- WA Tags
- Continue 1NF

1:471



Notes

Enter Map Description